

SECOND BRANCH

FRONT

APRIL

43' to 500'


28' to 500' wd 11'

48" cover
over stone

5-90's

5-9-02
added
LGMI

62'
1 1/2" PVC - Sec. 10 FENCE

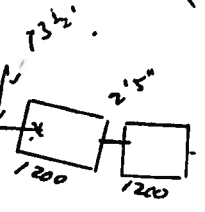

1000'

