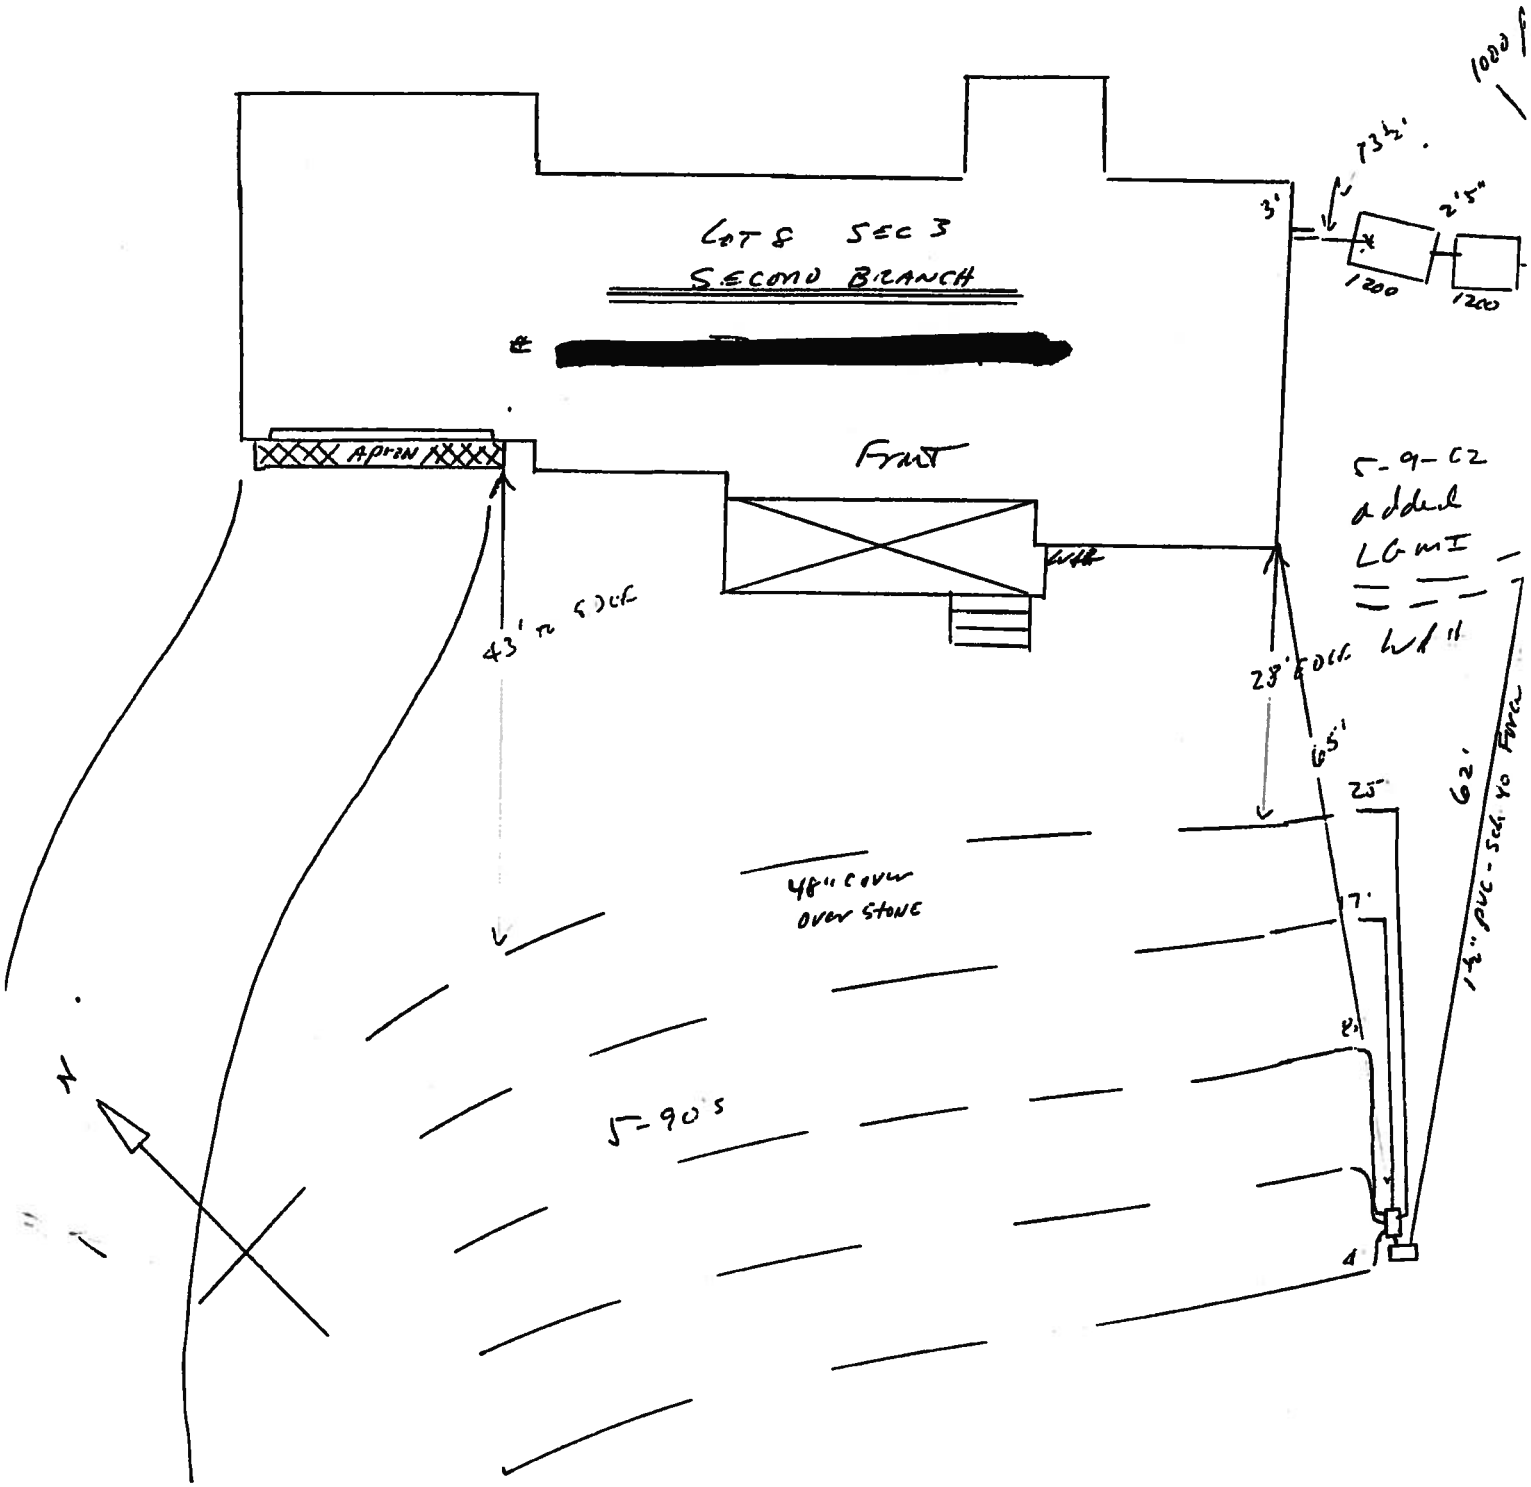

LOT 8 SEC 3
SECOND BRANCH
[redacted]
APRON
FRONT
WH
43' to SDCF
28' SDCF
65'
25'
7'
8'
4'
62'
1½" PVC - Sch 40 Force
48" cover over stone
5-90's
N
3'
73½'
2'5"
1200
1200
1000
5-9-02
added
LGMI